

# AS BUILT

## MILTON MARKETPLACE

10 BASSETT STREET,  
MILTON,  
MASSACHUSETTS



Location  
AS BUILT  
MILTON MARKETPLACE  
10 BASSETT STREET  
MILTON, MA

**C**  
Choo  
& Company, Inc.


One Billings Road Quincy, MA 02171  
617-786-7727 fax 617-786-7715

No.	Revision Date

Project No: 2022002  
Scale: AS NOTED  
Date: 08.28.24  
Drawn By: AR.EA

Drawing Name  
**AS BUILT  
FLOOR PLANS**

Sheet No.  
**A-0**

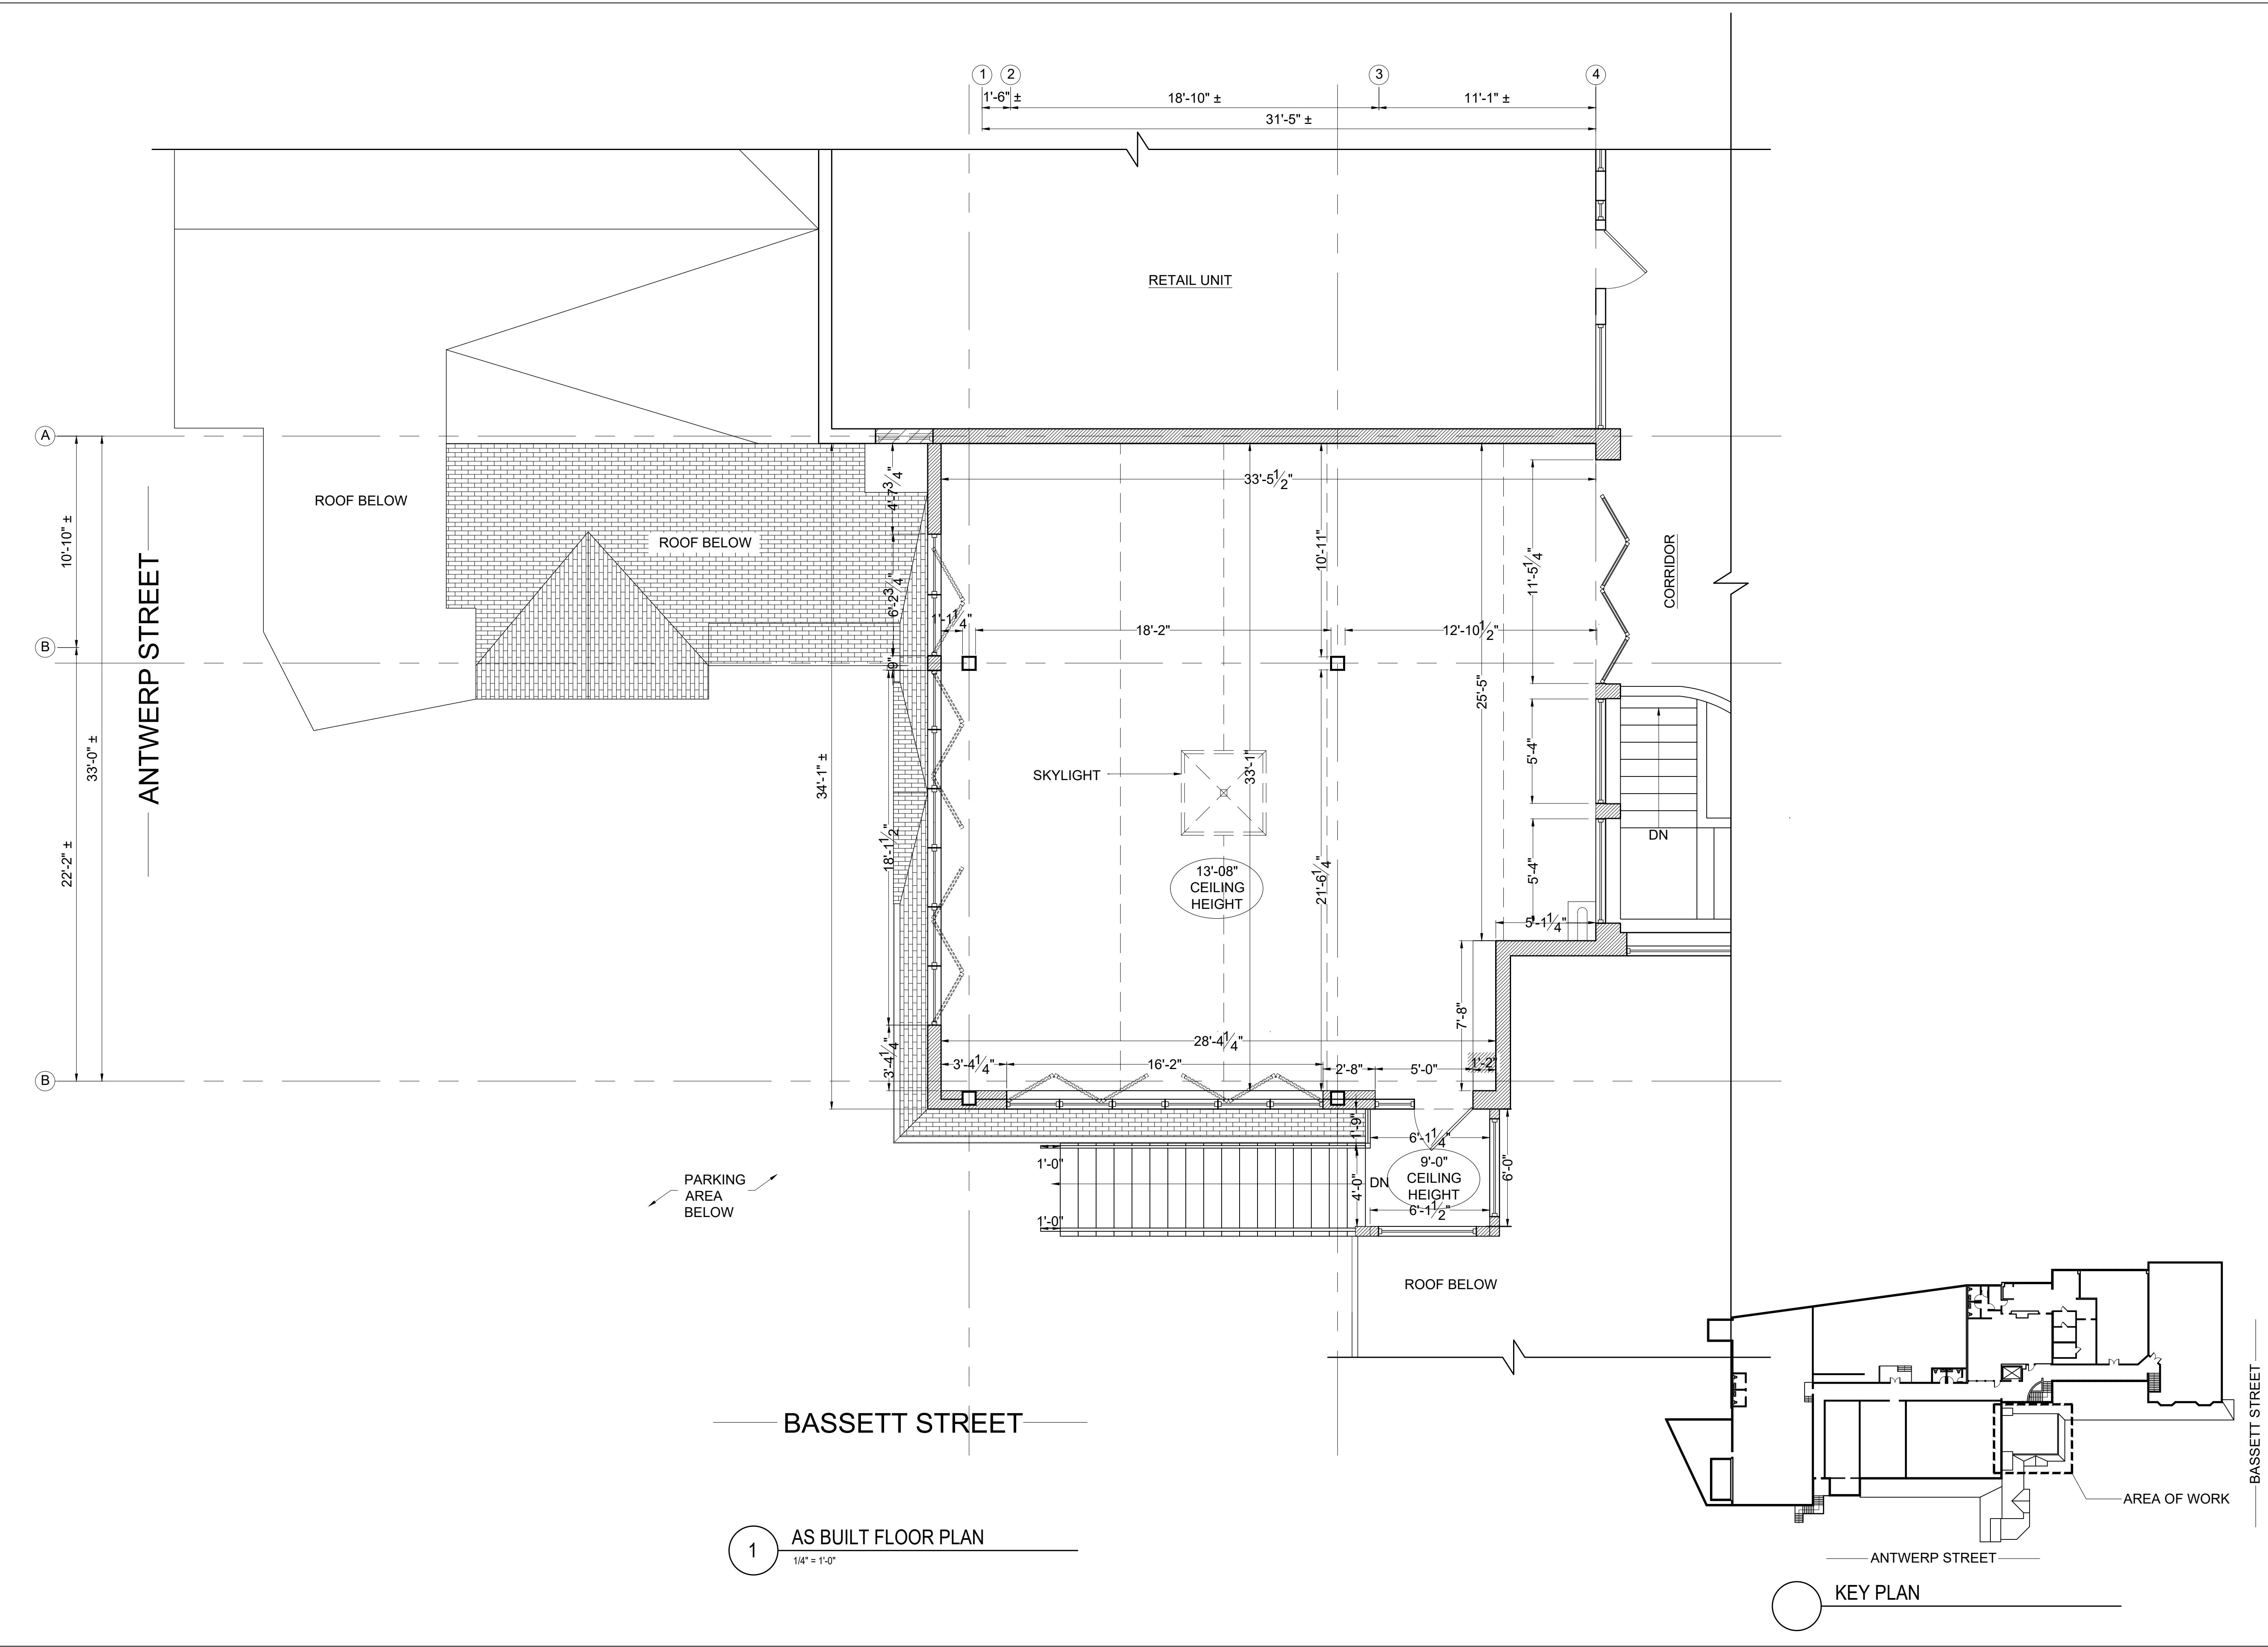

**AS BUILT  
MILTON MARKETPLACE  
10 BASSETT STREET  
MILTON, MA**

**Choo  
& Company, Inc.**

One Billings Road Quincy, MA 02171  
617-786-7727 fax 617-786-7715

No.	Revision Date
-----	---------------

Project No: 2022002  
Scale: AS NOTED  
Date: 08.28.24  
Drawn By: AR.EA

Drawing Name

**AS BUILT  
FLOOR PLANS**

Sheet No.

**A-1.0**

Location